


"J" AVE.

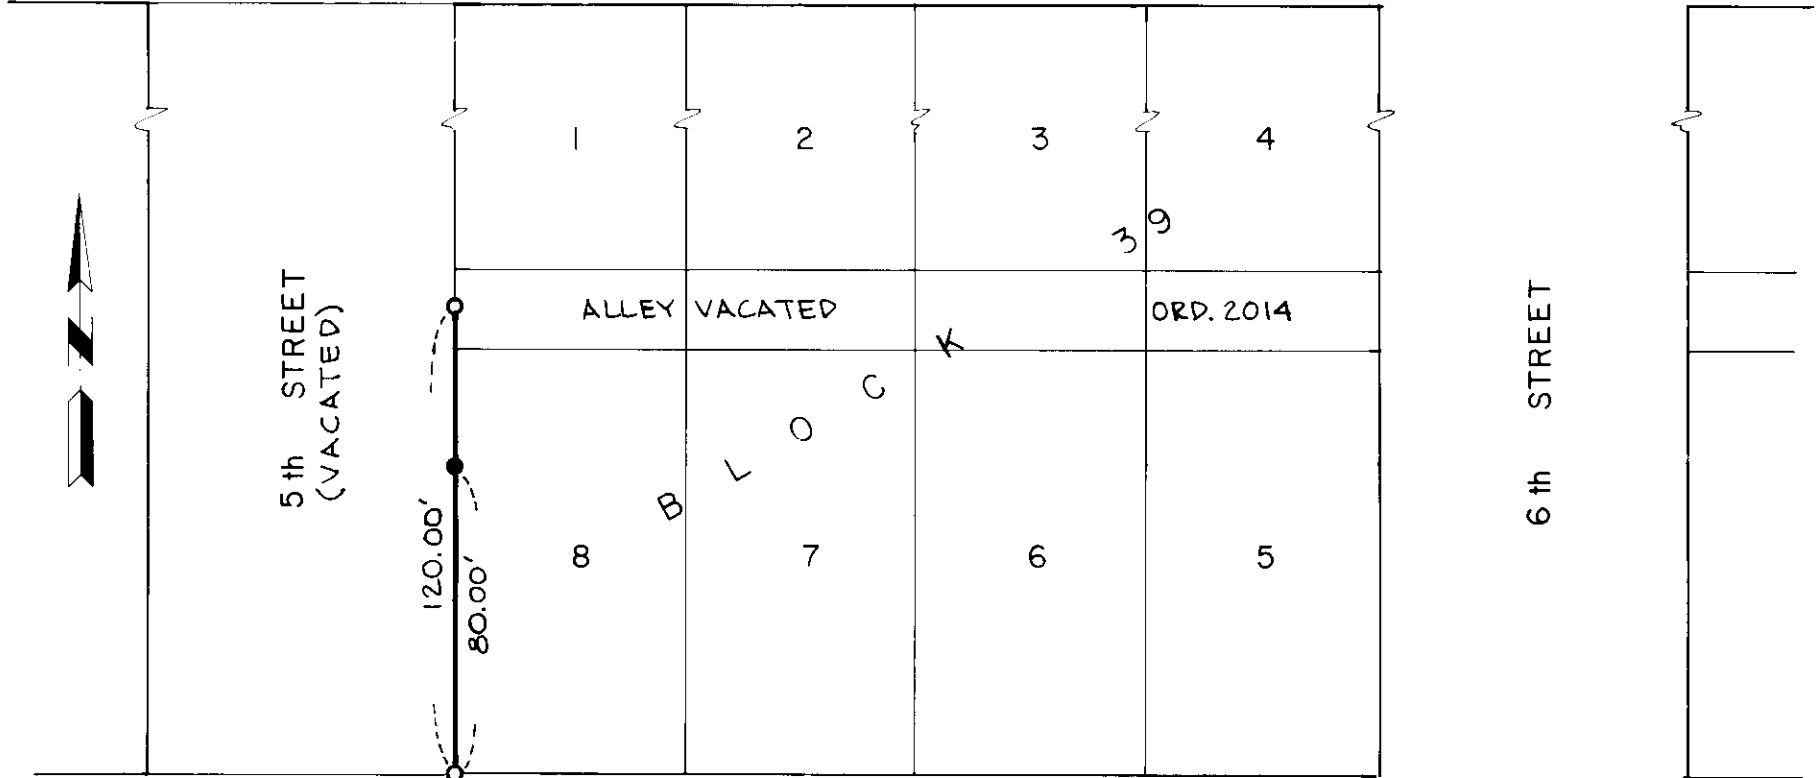

"I" AVE.

LEGEND

- FOUND 5/8" PIN FROM RECORD SURVEY 70-72
- SET 1/2" x 24" PIN WITH CAP MARKED AP+A.



<p>BLOCK 39 LOT 8 CHAPLINS ADDITION TO LA GRANDE</p>	
<p>FOR: DOUGLAS L. EUSTACE</p>	
<p>1" = 50'</p>	
<p>MAY 1977</p>	
<p>LA GRANDE • ENTREPRISE • OREGON</p>	

30-77